


ELEVATIONS AND INVERTS ARE REFERENCED TO GULF SURVEY PLAN REFERENCE: SEE PLAN NO. 58270 BY GULF SURVEY LTD.

LEGEND

- EXISTING EX.
- INVERT INV
- MANHOLE MH
- SANITARY SEWER SA
- STORM SEWER ST
- EX. HYDRANT
- EX. GATE VALVE
- EX. CURB STOP
- EX. VALVE OPERATOR
- EX. SANITARY MANHOLE
- EX. SEWER LINE
- EX. STORM LINE
- EX. CULVERT
- EX. WATER LINE
- EX. SPOT ELEVATION +23.4
- EX. STORM SEWER MANHOLE
- UTILITY POLE UP
- LIGHT POLE LP
- UNDERGROUND ELECTRICAL E
- EXISTING INVERT (23.73)
- TRAIL LINE
- MAIN CONTOUR (1M INTERVAL) 19.00
- INTERMEDIATE CONTOUR (0.25M INTERVAL)

- NOTES**
1. THIS TOPOGRAPHICAL SURVEY WAS EXECUTED DURING THE PERIOD OF JANUARY & FEBRUARY 2020.
 2. COORDINATES ARE REFERENCED TO P.E.I. DOUBLE STEREOGRAPHIC PROJECTION WITH NAD83 (CSRS) REFERENCE SYSTEM EPOCH 2010, ZONE 20, AND DERIVED FROM OBSERVATIONS FROM THE P.E.I. ACTIVE CONTROL NETWORK.
 3. ELEVATIONS ARE REFERENCED TO GEODETIC (METRIC) AND ARE BASED ON THE CANADIAN GEODETIC VERTICAL DATUM 2013.
 4. THE UNDERGROUND UTILITIES SHOWN HAVE BEEN LOCATED FROM FIELD SURVEY INFORMATION AND EXISTING RECORD DRAWINGS. DEREK A. FRENCH PROFESSIONAL SERVICES INC. MAKES NO GUARANTEES THAT THE UNDERGROUND UTILITIES SHOWN COMPRISE OF ALL SUCH UTILITIES IN THE AREA, EITHER IN-SERVICE OR ABANDONED. DEREK A. FRENCH PROFESSIONAL SERVICES INC. DOES CERTIFY THAT THE UNDERGROUND UTILITIES ARE LOCATED AS ACCURATELY AS POSSIBLE FROM AVAILABLE INFORMATION. DEREK A. FRENCH PROFESSIONAL SERVICES INC. HAS NOT PHYSICALLY LOCATED THE UNDERGROUND UTILITIES AND SHOULD BE VERIFIED PRIOR TO CONSTRUCTION.
 5. DUE TO SEASONAL CONDITIONS SUCH AS SNOW AND ICE, SOME INFRASTRUCTURE MAY BE MISSING FROM THE TOPOGRAPHICAL SURVEY.

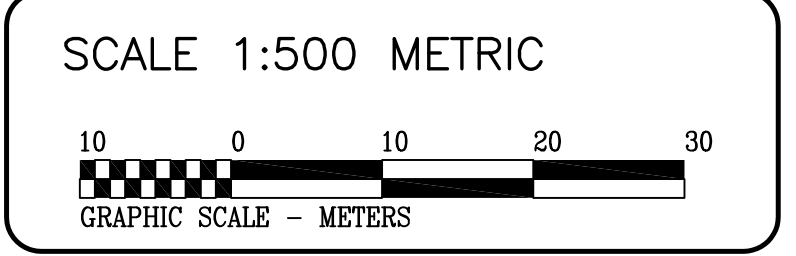

Prepared by:
Derek A. French
 Professional Services Inc.
 t: 902-394-2945
 dfrenchservices@gmail.com

Project Title
**UPEI CAMPUS
 NEW RESIDENCE**

Plan Title
**Topographical
 Survey**

Date Printed: FEB. 3, 2020
 Drawn by: JAS
 Job No. 20015
 Plan No. T1

STRUCTURE	TOP	INVERTS			
		NORTH	EAST	SOUTH	WEST
MH #B1	22.45	19.41	19.61	19.38	N/A
MH #4	25.99	23.72	23.60	N/A	23.68
MH #6	20.63	N/A	N/A	17.76	N/A
MH #6	26.13	N/A	21.86	25.20	21.89
MH #12	20.15	17.70	17.68	N/A	N/A
MH #13	19.84	17.62	18.36	17.66	N/A
MH #14	19.92	17.62	16.87	N/A	16.90
MH #15	19.62	N/A	N/A	16.44	16.49
MH #16	18.27	15.34	N/A	14.82	14.84
MH #17	20.03	N/A	N/A	N/A	N/A
MH #18	26.14	N/A	21.71	21.69	N/A
MH #219	24.56	23.01	22.56	N/A	22.78
MH #609	24.96	N/A	22.50	N/A	22.49
MH #786	22.22	19.77	N/A	17.80	18.02
MH #793	19.38	N/A	17.80	17.80	N/A
MH #932	19.28	N/A	N/A	N/A	N/A
MH #933	18.81	N/A	N/A	N/A	N/A
MH #941	23.47	N/A	21.61	20.00	N/A
MH #942	22.88	20.92	20.63	N/A	N/A
CB #B3	21.23	N/A	19.41	N/A	N/A
CB #B4	22.26	20.36	19.93	N/A	19.89
CB #B5	22.10	N/A	20.30	N/A	20.33
CB #B6	22.23	N/A	20.57	N/A	20.63
CB #B7	24.58	N/A	N/A	N/A	N/A
CB #B8	20.85	N/A	N/A	19.20	N/A
CB #B9	24.73	N/A	22.97	N/A	23.52
CB #B10	24.58	N/A	N/A	N/A	23.61
CB #B11	22.34	N/A	N/A	N/A	20.94
CB #B12	25.59	N/A	N/A	24.33	N/A
CB #B13	20.57	N/A	N/A	18.87	N/A
CB #B14	18.79	N/A	N/A	N/A	16.60
CB #B15	18.48	N/A	N/A	N/A	16.60
CB #B16	17.97	N/A	N/A	16.41	16.95
CB #B17	18.65	N/A	17.61	N/A	N/A
CB #B18	20.51	N/A	N/A	N/A	N/A
CB #B19	20.71	N/A	N/A	N/A	19.48
CB #B20	20.82	19.42	19.44	N/A	N/A
CB #B21	21.82	19.67	N/A	19.62	N/A
CB #B22	18.12	17.35	N/A	N/A	N/A
CB #B23	22.14	21.34	21.11	N/A	N/A
CB #B24	22.33	N/A	N/A	N/A	N/A
CB #940	23.22	N/A	N/A	N/A	23.22
CB #941	20.08	18.30	N/A	18.99	18.33